THIS DRAWING IS THE PROPERTY OF IS CONFIDENTIAL AND MUST NOT BE MADE PUBLIC OR COPIED, AND IS SUBJECT TO RETURN OR EXPUNGE. ALL RIGHTS OF INVENTION OR DESIGN ARE RESERVED

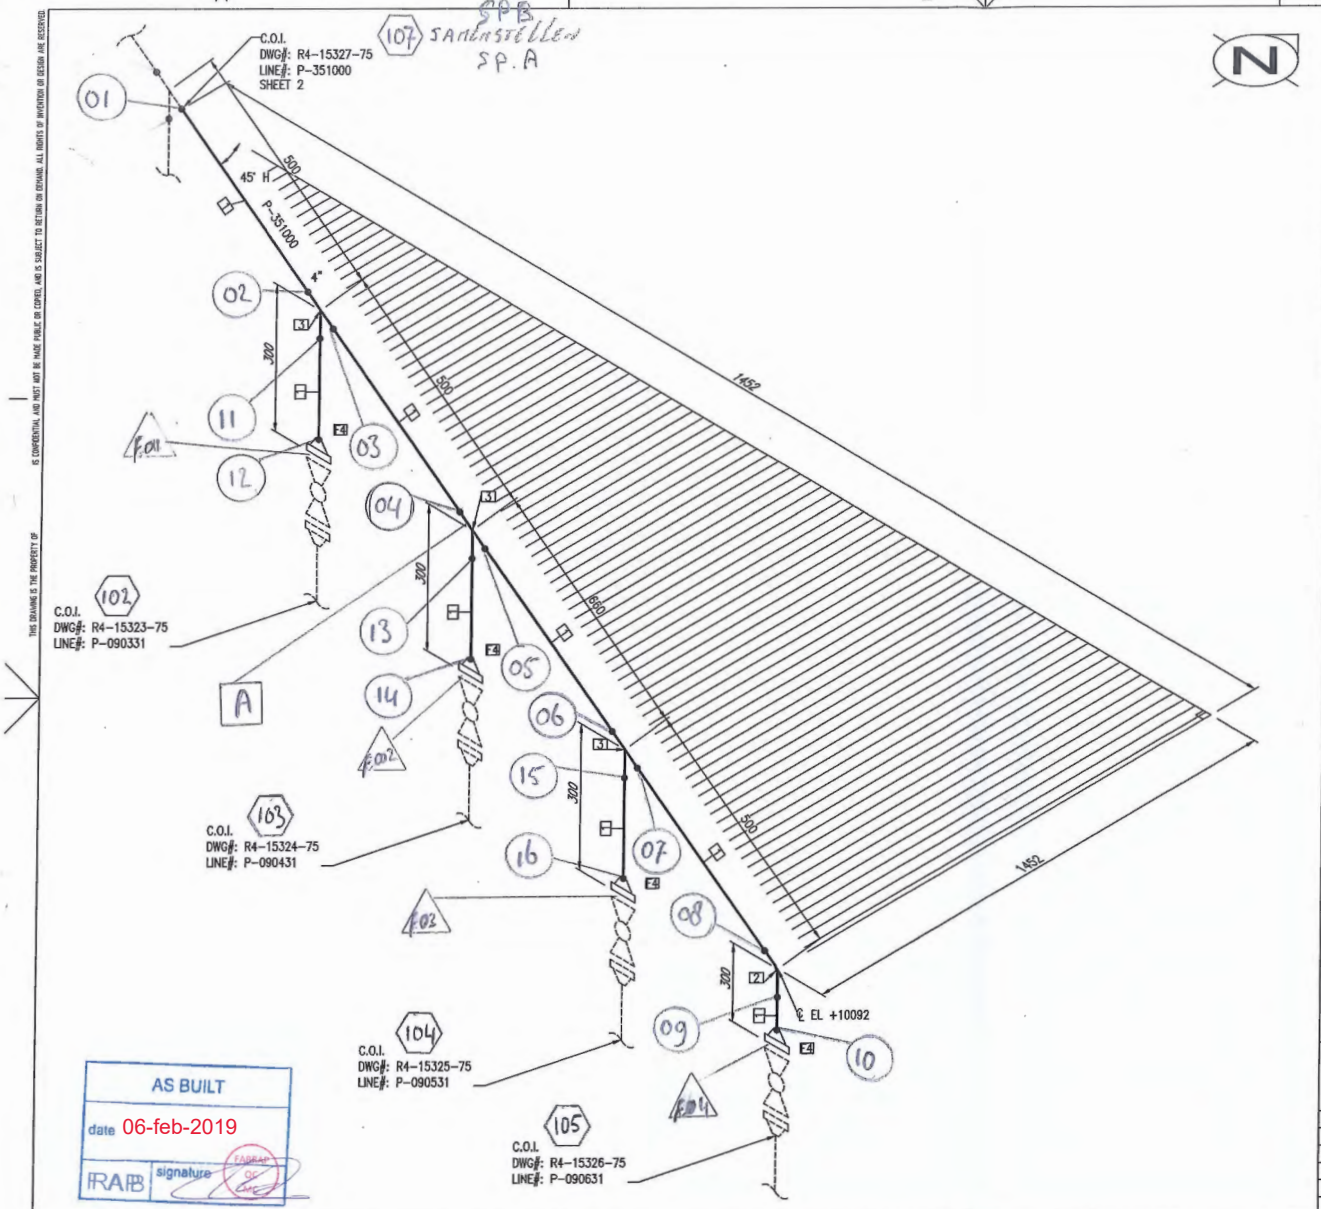

AS BUILT
date 06-feb-2019
FRAB signature

LINE DATA

PRESSURE	OPER. / DESIGN / TEST		16.5	24.75	BARG
TEMPERATURE	OPER. / DESIGN		90		°C
PED-class	FLUIDGROUP	1	CAT.	II	
	TABLE	6a	KVI	Yes	
X-RAY	10%		HEATTREATMENT	NO	
INSULATION	F3		TRACING	EL	
COATING	NO		PIPE CLASS	SSA	
MEDIUM	P				
AUTHORITY/NoBo-REGISTRATION					

BILL OF MATERIALS

POS No.	QTY	SIZE	DESCRIPTION
1	1.7M	4"	PIPE, SCH.10S, ASTM A312 GR.TP316L
2	1	4"	ELBOW 90° LR, SCH.10S, BW, ASTM A403 GR.WP316L
3	3	4"	TEE, SCH.10S, BW, ASTM A403 GR.WP316L
4	4	4"	FLANGE WN, 150#, SCH.10S, RF, ASTM A182 GR.316(L)

FOR CONSTRUCTION
date 07-jan-2019
FRAB signature

000106

Client Order No.: -
Site/Unit:
Client:

REV.	DESCRIPTION	BY	DATE	CHECK	DATE	APPR.	DATE
B	RELEASED FOR CONSTRUCTION	LMN	11/2018	LMN	11/2018		
A	FIRST ISSUE	MPK	11/2018	LMN	11/2018		

REMARKS

1. REFERENCE P&ID R1-3501-75
   REFERENCE LAY-OUT : R4-15075-51
   REFERENCE SUPPORT BOOK : R4-15600-52
   REFERENCE SPECIAL SUPPORT BOOK : R4-15606-52
2. ALL DIMENSIONS TO BE CHECKED BY CONTRACTOR BEFORE CONSTRUCTION

LEGEND

- GENERAL PIPE SHOE
- GUIDED PIPE SHOE
- FIXED POINT

FRAB

FABRAP - TRAINING
The Netherlands

DRAWING TITLE: ISOMETRIC
PLANT:

P-351000
SHEET 1 OF 3
AREA: 75

PROJECT NUMBER:	SCALE:	DRAWING NUMBER:	SIZE:	REV.:
-	N.A.	R4-15327-75	A2	B

CADfile: R4-15327-75 SHEET 001DWG